

~~N 2091~~ K3006

A

2-22-65

WATER WELL DRILLERS LOG

Date: 2-22, 1965, Driller: Autter Well Works County Hancock

(Name)

(1) Owner of Land: Melvin Cagle
(Name)

7320 Chef Menteur - N.O. La.
(Address)

(2) Location: SW 1/4, NE 1/4, Sec. 6 T9SR14W
3 miles W of Bay St Louis
(distance) (direction) (Nearest Town)

(3) Topography: flat
(Hilly) (Flat) (Level)

(4) Purpose of Well: domestic HOME
(Domestic Irrigation
Municipal, Industrial, Other)

Description & Color of Materials Sand, Clay, Red Clay, Shell, etc.	Thick- ness Feet	Depth Feet
<u>Clay</u>	<u>10</u>	<u>10</u>
<u>Sand</u>	<u>45</u>	<u>55</u>
<u>Sandy clay</u>	<u>37</u>	<u>92</u>
<u>Sand</u>	<u>27</u>	<u>119</u>


Information upon completion of well:

- (1) Diameter 2 inches.
- (2) Total Depth 119 feet.
- (3) Water Level 6 feet below top of ground. 114
- (4) Cased to ape, Size 2"
- (5) Screen: Size 2", Length 5'
- (6) Were any formations sealed against pollution?
 yes, no.

If YES depth of formation Surface

Why _____

Drillers Remarks: _____

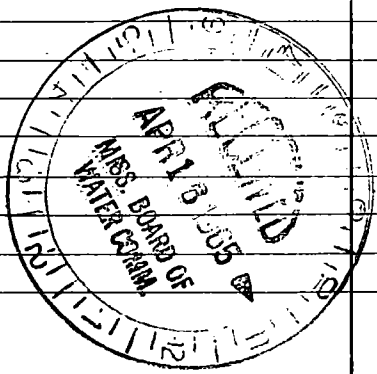

(Use Back Side)

Well No.

