

~~N-2097~~ K3007

3-9-65

WATER WELL DRILLERS LOG

A

Date: 3-9, 1965, Driller: Sutter Well Works County Hancock

(Name)

(1) Owner of Land: O. J. Angle
(Name)
510 Wagner St. - N.O. La.
(Address)

(2) Location: NE 1/4, SW 1/4, Sec. 20 T9S R14 W
1 miles S of Lakeshore
(distance) (direction) (Nearest Town)

(3) Topography: flat
(Hilly) (Flat) (Level)

(4) Purpose of Well: domestic Home
(Domestic Irrigation Municipal, Industrial, Other)

Description & Color of Materials Sand, Clay, Red Clay, Shell, etc.	Thick- ness Feet	Depth Feet
Clay	38	38
Sand	28	66
Clay	40	106
sand	23	129
Clay	99	228
fine sand	22	250
Sand	51	301
Clay	23	324
fine sand	11	335
Sand	37	372

Information upon completion of well:

(1) Diameter 2 inches.

(2) Total Depth 372 feet. flat

(3) Water Level 1 above feet below top of ground.

(4) Cased to all, Size 2"


(5) Screen: Size 2", Length 10'

(6) Were any formations sealed against pollution?
 yes, no,

If YES depth of formation _____

Why _____

Drillers Remarks: _____

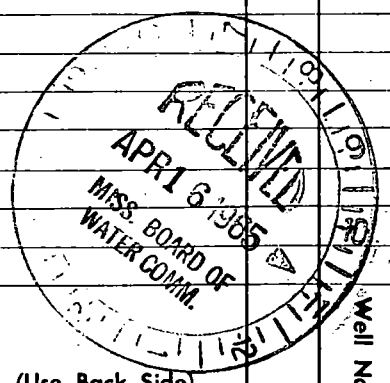

(Use Back Side)

Well No. _____

Handwritten notes and scribbles at the top of the page, including a large '1' and some illegible text.

Main body of handwritten notes, including a large '1' and various illegible scribbles and lines.