

HANCOCK

MISSISSIPPI BOARD OF WATER COMMISSIONERS

~~V 20 24~~ K3009

5-14-65

WATER WELL DRILLERS LOG

Date: 5-14, 1965, Driller: Sutton Well Works County Hancock
(Name)

(1) Owner of Land: Ray G. Lucas, Jr.
(Name)
Algiers, La.
(Address)

(2) Location: NW 1/4, SE 1/4, Sec. 6 T9S R14, W10
3 miles W of Waveland
(distance) (direction) (Nearest Town)

(3) Topography: flat
(Hilly) (Flat) (Level)

(4) Purpose of Well: domestic home
(Domestic Irrigation
Municipal, Industrial, Other)

Description & Color of Materials Sand, Clay, Red Clay, Shell, etc.	Thick- ness Feet	Depth Feet
<u>Clay</u>	<u>7</u>	<u>7</u>
<u>Sand</u>	<u>49</u>	<u>56</u>
<u>Clay</u>	<u>42</u>	<u>98</u>
<u>fine sand</u>	<u>17</u>	<u>115</u>
<u>Clay</u>	<u>34</u>	<u>149</u>
<u>sand</u>	<u>10</u>	<u>159</u>

Information upon completion of well:

(1) Diameter 2 inches.

(2) Total Depth 159 feet.

(3) Water Level 8 feet below top of ground.

(4) Cased to app, Size 2"


(5) Screen: Size 2", Length 5'

(6) Were any formations sealed against pollution?
 yes, no.

If YES depth of formation _____

Why _____

Drillers Remarks: _____

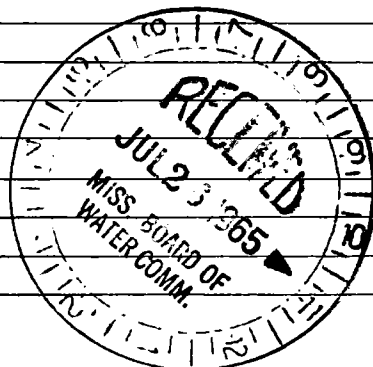

(Use Back Side)

Well No.

1. 11112

11112
11112
