

HANCOCK

MISSISSIPPI BOARD OF WATER COMMISSIONERS

~~A-7095~~ K 3010

5-21-65

WATER WELL DRILLERS LOG

Date: 5/21, 1965, Driller: Little Wood Works County Hancock
(Name)

(1) Owner of Land: L. R. Cahoon
(Name)
Waveland, Miss.
(Address)

(2) Location: SW 1/4, SW 1/4, Sec. 3 T9S R14W
1 miles N of Waveland
(distance) (direction) (Nearest Town)

(3) Topography: flat
(Hilly) (Bar) (Level)

(4) Purpose of Well: domestic home
(Domestic Irrigation
Municipal, Industrial, Other)

Description & Color of Materials Sand, Clay, Red Clay, Shell, etc.	Thick- ness Feet	Depth Feet
<u>sand</u>	<u>40</u>	<u>40</u>
<u>clay</u>	<u>53</u>	<u>93</u>
<u>Clay - sand str.</u>	<u>114</u>	<u>207</u>
<u>sand</u>	<u>8</u>	<u>215</u>
<u>Clay - sand str.</u>	<u>37</u>	<u>252</u>
<u>sand</u>	<u>28</u>	<u>280</u>

Information upon completion of well:

(1) Diameter 2 inches.

(2) Total Depth 280 feet.

(3) Water Level 17 feet below top of ground.

(4) Cased to all, Size 2"


(5) Screen: Size 2", Length 5'

(6) Were any formations sealed against pollution?
_____ yes, no.

If YES depth of formation _____

Why _____

Drillers Remarks: _____

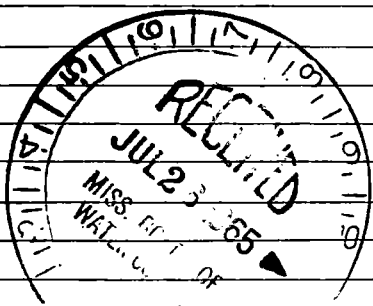

(Use Back Side)

Well No.

Handwritten header text, possibly a title or date, located at the top of the page.

Main body of handwritten text, appearing to be a list or series of entries, possibly organized in columns.

Small handwritten mark or symbol, possibly a cross or a specific character.

Small handwritten notes or symbols, possibly a signature or a specific mark.