

HANCOCK

MISSISSIPPI BOARD OF WATER COMMISSIONERS

~~A 202~~ K3011

6-21-65

WATER WELL DRILLERS LOG

Date: 6-21, 1965, Driller: Autter Well Works County Hancock

(Name)

(1) Owner of Land: Bert Courrage
(Name)
Lakeshore
(Address)

(2) Location: NW 1/4, SE 1/4, Sec. 7E T9S R14W
1 miles E of Lakeshore
(distance) (direction) (Nearest Town)

(3) Topography: flat
(Hilly) (Flat) (Level)

(4) Purpose of Well: domestic home
(Domestic Irrigation
Municipal, Industrial, Other)

Description & Color of Materials Sand, Clay, Red Clay, Shell, etc.	Thick- ness Feet	Depth Feet
<u>Clay</u>	<u>150</u>	<u>150</u>
<u>Sand</u>	<u>33</u>	<u>184</u>
<u>Clay</u>	<u>65</u>	<u>249</u>
<u>sand</u>	<u>37</u>	<u>286</u>


Information upon completion of well:

- (1) Diameter 2 inches.
- (2) Total Depth 286 feet.
- (3) Water Level 3 feet below top of ground. 276
- (4) Cased to top, Size 2"
- (5) Screen: Size 2", Length 10'
- (6) Were any formations sealed against pollution?
no

If YES depth of formation _____

Why _____

Drillers Remarks: _____

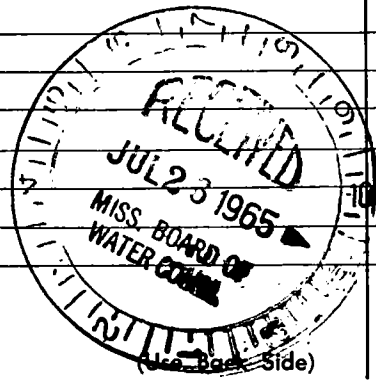

Well No. _____

Handwritten header or title at the top of the page, possibly including a date or reference number.

100 100
100 100
100 100
100 100

Handwritten notes or a list of items, possibly related to the numbers on the left.

Main body of handwritten text, appearing to be a list or a series of entries, possibly organized in columns.

Handwritten text or a signature located in the lower right quadrant of the page.

Handwritten text or a signature located in the lower middle section of the page.

Handwritten text or a signature located in the lower right section of the page.