

HANCOCK

~~A 2028~~
7-27-65

K3013

WATER WELL DRILLERS LOG

Date: 7-27, 1965, Driller: Butter Well Works County Hancock

(Name)

(1) Owner of Land: Cornelius Ladner
(Name)

Bay St. Louis Miss.
(Address)

(2) Location: NE 1/4, SE 1/4, Sec. 34 T8S R14 W

1 miles N of Waveland
(distance) (direction) (Nearest Town)

(3) Topography: flat
(Hilly) (Flat) (Level)

(4) Purpose of Well: domestic, Home
(Domestic Irrigation
Municipal, Industrial, Other)

Description & Color of Materials Sand, Clay, Red Clay, Shell, etc.	Thick- ness Feet	Depth Feet
Clay	10	10
sand	48	58
Clay - fine sand streaks	344	402
sand	84	476
Clay	41	517
sand	17	534
Clay	46	580
sand	43	623
Clay	15	638
sand	132	770
Clay	42	812
sand	21	833
Clay	126	959
sand	11	970
Clay	11	981
sand	52	1033
Clay	21	1054
sand	86	1140

Information upon completion of well:

(1) Diameter 3 inches.

(2) Total Depth 1140 feet. flow

(3) Water Level 27 feet above below top of ground.

(4) Cased to all, Size 3"

(5) Screen: Size 3", Length 20'


(6) Were any formations sealed against pollution?

yes, no.

If YES depth of formation _____

Why _____

Drillers Remarks: _____

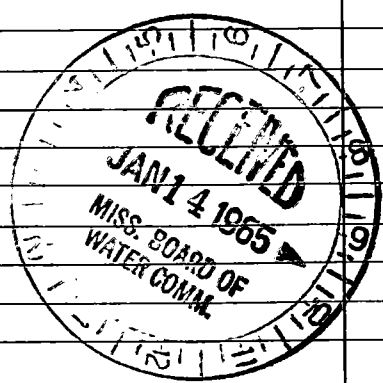

(Use Back Side)

Well No.

