

HANCOCK

MISSISSIPPI BOARD OF WATER COMMISSIONERS

~~A 2032~~ K3014

9-8-65

WATER WELL DRILLERS LOG

Date: 9-8, 1965, Driller: Sutton Well Works County Hancock
(Name)

(1) Owner of Land: H. S. Kimbrough
(Name)

806 N. Beach, Bay St. Louis, Miss
(Address)

(2) Location: SW 1/4, NE 1/4, Sec. 3 T28R14W

1 miles N of Waveland
(distance) (direction) (Nearest Town)

(3) Topography: flat
(Hilly) (Flat) (Level)

(4) Purpose of Well: domestic home
(Domestic Irrigation
Municipal, Industrial, Other)

Description & Color of Materials Sand, Clay, Red Clay, Shell, etc.	Thick- ness Feet	Depth Feet
Clay	17	17
Sand	41	58
Clay - sand streaks	47	105
sand	21	126
Clay	22	148
Red. gravel	22	170

Information upon completion of well:

(1) Diameter 2 inches.

(2) Total Depth 170 feet.

(3) Water Level 9 feet below top of ground.

(4) Cased to 165 feet, Size 2"


(5) Screen: Size 2", Length 5'

(6) Were any formations sealed against pollution?
 yes, no.

If YES depth of formation Surface

Why

Drillers Remarks:

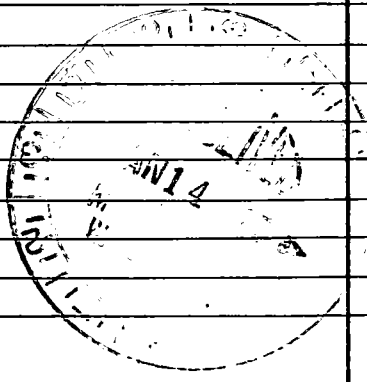

(Use Back Side)

Well No.

Handwritten notes at the top of the page, including the word "Lecture" and some illegible scribbles.

Handwritten notes in the upper middle section, possibly starting with "Lecture 1" and "Introduction".

Handwritten notes in the middle section, including the word "Lecture" and some illegible text.

Handwritten notes in the lower middle section, including the word "Lecture" and some illegible text.

Handwritten notes in the lower section, including the word "Lecture" and some illegible text.

Handwritten notes in the lower section, including the word "Lecture" and some illegible text.

Handwritten notes in the lower section, including the word "Lecture" and some illegible text.

Handwritten notes in the lower section, including the word "Lecture" and some illegible text.

Handwritten notes at the bottom of the page, including the word "Lecture" and some illegible text.