

HANCOCK MISSISSIPPI BOARD OF WATER COMMISSIONERS

~~N 2033~~ K3015

9-22-65

WATER WELL DRILLERS LOG

Date: 9-22, 1965, Driller: Sutter Well Wks. County Hancock

(Name)

(1) Owner of Land: J. P. Grooms  
(Name)

Gen. Delivery - Bay St Louis, Miss  
(Address)

(2) Location: NE 1/4, NW 1/4, Sec. 3 T9S R14, W

1 miles N of Waveland  
(distance) (direction) (Nearest Town)

(3) Topography: flat  
(Hilly) (Flat) (Level)


(4) Purpose of Well: domestic Home  
(Domestic Irrigation  
Municipal, Industrial, Other)

Description & Color of Materials Sand, Clay, Red Clay, Shell, etc.	Thick- ness Feet	Depth Feet
Clay	19	19
sand	29	48
clay	40	88
sand	45	133
clay	21	154
sand	19	173

Information upon completion of well:

- (1) Diameter 2 inches.
- (2) Total Depth 173 feet.
- (3) Water Level 12 feet below top of ground.
- (4) Cased to 168 all, Size 2"
- (5) Screen: Size 2", Length 5'
- (6) Were any formations sealed against pollution?  
no

If YES depth of formation \_\_\_\_\_  
Why \_\_\_\_\_  
Drillers Remarks: \_\_\_\_\_

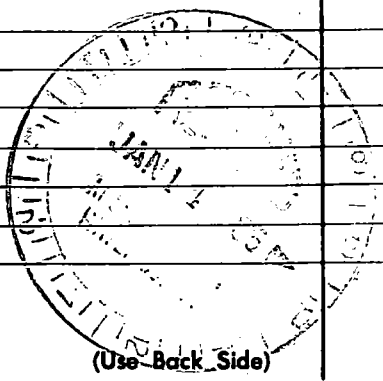

Well No. \_\_\_\_\_

