

K3018

Hancock

11-20-67

11-67

MISSISSIPPI
BOARD OF WATER COMMISSIONERS
416 North State Street
Jackson, Mississippi 39201

WATER WELL DRILLERS LOG

11-30 1967
date well completed

Dutter Well Works
firm name

Hancock
county well located

LANDOWNER: Salvatore Enna

412 So. Derogenius St
New Orleans La.
(mailing address)

description of formations encountered

from to

Clay	0	13
Sand	13	28
Clay	28	87
Sand	87	120
Clay	120	169
Sand	169	189

WELL LOCATION:

sec. 7 T. 9 N R. 14 E
S W W
3 miles W of Waveland
(distance) (direction) (nearest town)

WELL PURPOSE: home
(home, irrigation, municipal, industrial)

WELL COMPLETION DATA:


- (1) diameter (inches) 2
- (2) total depth (feet) 189
- (3) static water level (feet) 7 below above top of ground.
- (4) casing galv. 184'
(material) (depth)
- 2"
(size) if telescope see back.
- (5) screen 5' 184'
(length) (depth to top)
- 2" Stainless Steel
(size) (material)
- (6) pump unknown
(HP) (yield gpm)

(type power)
(7) electric log no
(yes or no)

(organization running log)

(8) how well bottom plugged BP Valve

DRILLERS REMARKS:

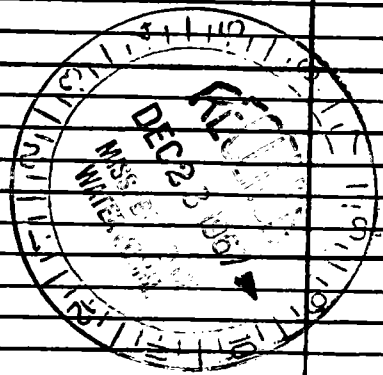

If well telescopes please sketch and show depths.

GROUND LEVEL

	X		

SECTION 7

Please indicate well location X.

ADDITIONAL INFORMATION

If more than one screen, show locations of each on sketch.