

HANCOCK

MISSISSIPPI BOARD OF WATER COMMISSIONERS

~~N 2039~~ K3021

11-11-65

WATER WELL DRILLERS LOG

Date: 11-11, 1965, Driller: Lutter Well Works County Hancock
(Name)

(1) Owner of Land: Chas. Dickson
(Name)

Wauvland
(Address)

(2) Location: SW 1/4, NE 1/4, Sec. 34 T85R14, W

1 miles N, of Wauvland
(distance) (direction) (Nearest Town)

(3) Topography: flat
(Hilly) (Flat) (Level)

(4) Purpose of Well: domestic Home
(Domestic Irrigation
Municipal, Industrial, Other)

Description & Color of Materials
Sand, Clay, Red Clay, Shell, etc.

Thick-
ness
Feet

Depth
Feet

Clay

11

11

sand

43

54

Clay

45

99

sand

8

107

Clay - sand streaks

137

244

sand

18

262

Information upon completion of well:

(1) Diameter 2 inches.

(2) Total Depth 262 feet.

(3) Water Level 12 feet below top of ground.

(4) Cased to all, Size 2"

(5) Screen: Size 2", Length 10'


(6) Were any formations sealed against pollution?

no yes, no.

If YES depth of formation _____

Why _____

Drillers Remarks: _____

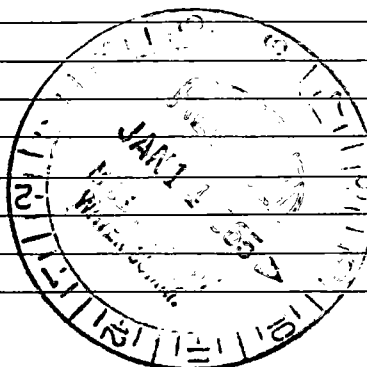

(Use Back Side)

Well No.

Handwritten header or title at the top of the page, possibly including a date or page number.

Handwritten notes on the left side of the page, possibly a list or a set of instructions.

Main body of handwritten text on the right side of the page, appearing to be a detailed explanation or a set of steps.

Large section of handwritten text at the bottom of the page, possibly a conclusion or a summary of the content above.