

HANCOCK

MISSISSIPPI BOARD OF WATER COMMISSIONERS

~~N 2048~~

K3022

11-30-65

WATER WELL DRILLERS LOG

Date: 11-30, 1965, Driller: Sutter Well Wks. County Hancock

(Name)

(1) Owner of Land: 2. J. Strong
 (Name)
Bay St. Louis, Miss.
 (Address)

(2) Location: SE 1/4, SE 1/4, Sec. 34 T8S R14W
1 miles N, of Waveland
 (distance) (direction) (Nearest Town)

(3) Topography: flat
 (Hilly) (Flat) (Level)

(4) Purpose of Well: domestic home
 (Domestic Irrigation
 Municipal, Industrial, Other)

Description & Color of Materials Sand, Clay, Red Clay, Shell, etc.	Thick- ness Feet	Depth Feet
Clay	7	7
Sand	47	54
Clay	11	65
sand	19	84
Clay	74	158
Sand	17	175
Clay	66	241
sand	24	265

Information upon completion of well:

(1) Diameter 2 inches.

(2) Total Depth 265 feet.

(3) Water Level 12 feet below top of ground.

(4) Cased to 66, Size 2"


(5) Screen: Size 2", Length 10'

(6) Were any formations sealed against pollution?
 yes, no.

If YES depth of formation surface

Why _____

Drillers Remarks: _____

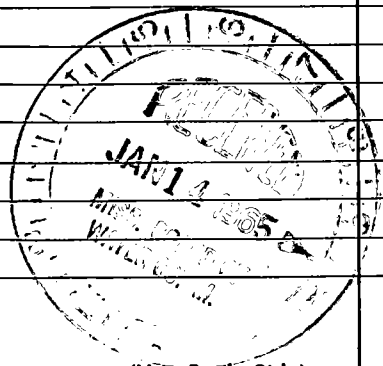

(Use Back Side)

Well No.

