

~~N 2043~~ K3025

M

WATER WELL DRILLERS LOG

12-4-62

Date: Dec. 4, 1962, Driller: M & B Drilling Co. County Hancock
 (Name)


(1) Owner of Land: Hancock Homes
 (Name)
P.O. Box Pass Christian, Miss.
 (Address)
 Bay Side Park 3rd Division
 (2) Location: 1/4 Sec. 5 T. 14 R. 14
1/4 mile south Highway 90.
6 miles West of Bay St. Louis
 (distance) (direction) (Nearest Town)
 (3) Topography: Flat
 (Hilly) (Flat) (Level)
 (4) Purpose of Well: Domestic Home
 (Domestic Irrigation
 Municipal, Industrial, Other)

Description & Color of Materials Sand, Clay, Red Clay, Shell, etc.	Thick- ness Feet	Depth Feet
Clay	18	18
Black Sand	30	48
Black Clay	10	58
Blue Clay + Lam Shells	32	90
White coarse Sand	33	123
Blue Clay	22	145
Blue Clay + Sand Brakes	15	160
Coarse white sand		
Heavy Black Gravel, etc.	18	178
		on

Information upon completion of well:

(1) Diameter 2" X 1 1/2" inches.
 (2) Total Depth 173 feet.
 (3) Water Level 6 feet below top of ground.
 Balance 1 1/4"
 (4) Cased to 167 FT, Size 42 FT 2"
 (5) Screen: Size 2 1/4" X 8/16", Length 5 FT.
 (6) Were any formations sealed against pollution?
 _____ yes, _____ no.

If YES depth of formation _____
 Why _____
 Drillers Remarks: _____

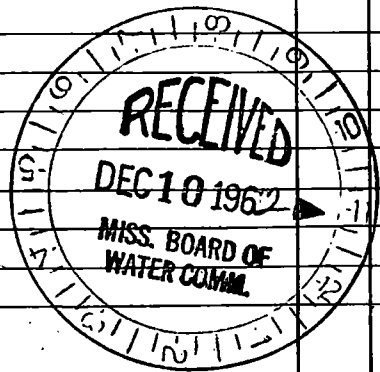

(Use Back Side)

Well No.

