

HANCOCK

MISSISSIPPI BOARD OF WATER COMMISSIONERS

~~N 2045~~ K3027

12-26-65 WATER WELL DRILLERS LOG

Date: 12-26, 1965, Driller: Sutter Well Works County Hancock

(Name)

(1) Owner of Land: First Assembly of  
(Name) God Church  
Waveland, Miss.  
(Address)

Description & Color of Materials  
Sand, Clay, Red Clay, Shell, etc.

Thick-  
ness  
Feet

Depth  
Feet

Clay	10	10
Sand	33	43
Clay	137	180
Sand	25	205
Clay	30	235
Sand	35	270

(2) Location: SE 1/4, SE 1/4, Sec. 34 T85R 14W  
1 miles N of Waveland  
(distance) (direction) (Nearest Town)

(3) Topography: flat  
(Hilly) (Flat) (Level)

(4) Purpose of Well: Church & domestic  
(Domestic Irrigation  
Municipal, Industrial, Other)


Information upon completion of well:

- (1) Diameter 2 inches.
- (2) Total Depth 270 feet.
- (3) Water Level 12 feet below top of ground.
- (4) Cased to 260, Size 2"
- (5) Screen: Size 2", Length 10'
- (6) Were any formations sealed against pollution?  
no

If YES depth of formation \_\_\_\_\_

Why \_\_\_\_\_

Drillers Remarks: \_\_\_\_\_

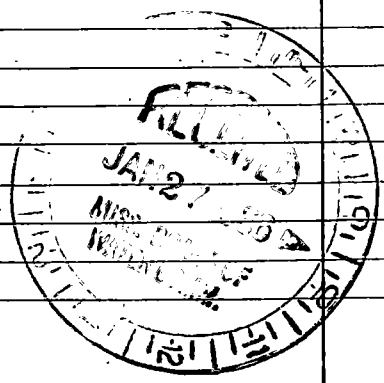

(Use Back Side)

Well No. \_\_\_\_\_

Journal of the ...

1870  
1871  
1872  
...

...

