

HANCOCK

MISSISSIPPI BOARD OF WATER COMMISSIONERS

~~N 7046~~

K 3028

12-28-65

WATER WELL DRILLERS LOG

Date: 12-28, 19 65, Driller: Sutter Well Works County Hancock

(Name)

(1) Owner of Land: A. J. Butz (Name)

Waveland, Miss (Address)

(2) Location: NE 1/4, NE 1/4, Sec. 3 T95R14W

1 miles N of Waveland (distance) (direction) (Nearest Town)

(3) Topography: flat (Hilly) (Flat) (Level)

(4) Purpose of Well: Domestic Home (Domestic Irrigation Municipal, Industrial, Other)

Description & Color of Materials Sand, Clay, Red Clay, Shell, etc.

Thick-ness Feet

Depth Feet

Clay 10 10
sand 28 38
Clay 8 8 126
sand 48 174

Information upon completion of well:

(1) Diameter 2 inches.

(2) Total Depth 174 feet.

(3) Water Level 9 feet below top of ground. 169

(4) Cased to all, Size 2"


(5) Screen: Size 2", Length 5'

(6) Were any formations sealed against pollution? yes, no. [checked]

If YES depth of formation

Why

Drillers Remarks:

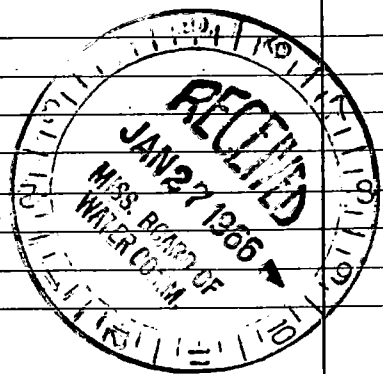

Well No.

(Use Back Side)

Handwritten text at the top of the page, possibly a title or header.

Main body of handwritten text, appearing to be a list or series of entries.

Continuation of handwritten text, possibly including a table or structured list.

Bottom section of handwritten text, possibly concluding remarks or a signature.