

Hancock

~~N 20 St~~ K 3033

6-9-66

MISSISSIPPI BOARD OF WATER COMMISSIONERS

WATER WELL DRILLERS LOG

Date: 6-9, 1966, Driller: Int'l Well Works County Hancock
 (When well drilled) (Name) (Where well is located)

(1) Owner of Land: H.C. WISTERICH

(Name)

4950 Music St. - New Orleans

(Address)

(2) Location: SE ~~NE~~ $\frac{1}{4}$, NE $\frac{1}{4}$, Sec. 9 T25R 14W

1 miles N, of Waveland
(distance) (direction) (Nearest Town)

(3) Topography: level

(Hilly) (Flat) (Level)

(4) Purpose of Well: domestic home

(Domestic Irrigation
Municipal, Industrial, Other)

Description & Color of Materials
Sand, Clay, Red Clay, Shell, etc.

Thick-
ness
Feet

Depth
Feet

Clay

8

8

Sand

53

61

Clay

94

155

Sand

18

173

Information upon completion of well:

(1) Diameter 2 inches.

(2) Total Depth 173 feet.

(3) Water Level 10 feet below top of ground.

(4) Cased to cell, Size 2"

(5) Screen: Size 2", Length 5'

(6) Were any formations sealed against pollution?

no, yes, no.

If YES depth of formation _____


Why _____

Drillers Remarks: _____

Yield in gpm: 10

Size pump: Unknown

Type power: _____

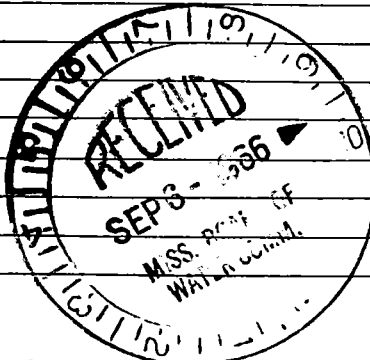

1870

1871

1872

1900