

Hancock K3038

~~AT 9-05~~
9-66

MISSISSIPPI BOARD OF WATER COMMISSIONERS

WATER WELL DRILLERS LOG

Date: 9-19, 1966, Driller: Int'l Well Works County Hancock
(When well drilled) (Name) (Where well is located)

(1) Owner of Land: Abe Williams
(Name)
Lakeshore Trms
(Address)

(2) Location: SW 1/4, SW 1/4, Sec. 18 T9S R14 W
1 miles N, of Lakeshore
(distance) (direction) (Nearest Town)

(3) Topography: flat
(Hilly) (Flat) (Level)

(4) Purpose of Well: domestic home
(Domestic Irrigation, Municipal, Industrial, Other)


Description & Color of Materials Sand, Clay, Red Clay, Shell, etc.	Thick- ness Feet	Depth Feet
Clay	17	17
sand	19	36
Clay	44	80
sand	47	127
Clay	43	170
sand	45	215

Information upon completion of well:

(1) Diameter 2 inches.
(2) Total Depth 215 feet.
(3) Water Level 6 feet below top of ground.
(4) Cased to 210, Size 2"
(5) Screen: Size 2", Length 5'
(6) Were any formations sealed against pollution?
no yes, no.

If YES depth of formation _____
Why _____


Drillers Remarks: _____
Yield in gpm: 12
Size pump: 1/2 hp
Type power: elec

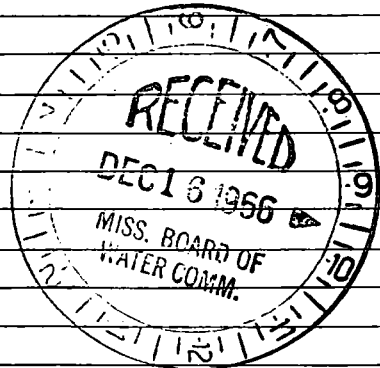

17
18
19
Clay
Sand
Gravel
Silt
Loam

100
90
80
70
60
50
40
30
20
10
0

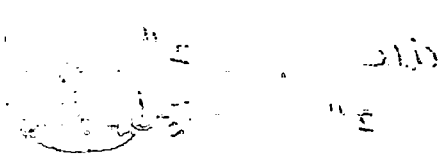

100
90
80
70
60
50
40
30
20
10
0