

K 3041

Hancock

~~2-20-59~~

3-67

MISSISSIPPI  
 BOARD OF WATER COMMISSIONERS  
 416 North State Street  
 Jackson, Mississippi 39201

WATER WELL DRILLERS LOG

3-28 1967 SUTTER WELL WORKS HANCOCK  
 date well completed firm name county well located

LANDOWNER: Fred Klein  
 Bay St Louis Miss

description of formations encountered	from	to
Clay	0	8
sand	8	32
Clay - sand streaks	32	121
Clay	121	178
sand	178	210
Clay	210	226
sand	226	244
Clay	244	280
sand	280	317

(mailing address)

WELL LOCATION:

sec. 8 T 9 S R 14 E  
 1 miles N of Clearmont  
 (distance) (direction) (nearest town)

WELL PURPOSE: home  
 (home, irrigation, municipal, industrial)


WELL COMPLETION DATA:

- (1) diameter (inches) 2
- (2) total depth (feet) 317
- (3) static water level (feet) 8 below top of ground
- (4) casing galv. 307' (material) (depth)
- (size) If telescope see back.
- (5) screen 10' 307' (length) (depth to top)
- 2" stainless steel (size) (material)
- (6) pump 1/2 15 (HP) (yield gpm)
- elec. (type power)
- (7) electric log no (yes or no)

(organization running log)


(8) how well bottom plugged B.P. Value

DRILLERS REMARKS:

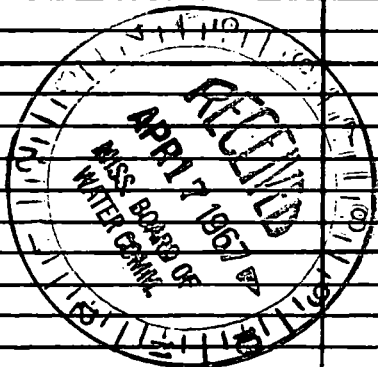

If well telescopes please sketch and show depths.

GROUND LEVEL

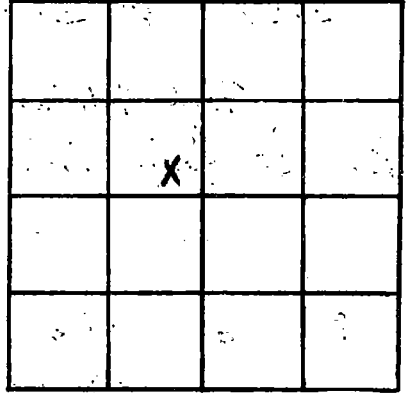

SECTION 8

Please indicate well location X.

ADDITIONAL INFORMATION

If more than one screen, show locations of each on sketch.