

K3042

Hancock

4-67

MISSISSIPPI  
 BOARD OF WATER COMMISSIONERS  
 416 North State Street  
 Jackson, Mississippi 39201

WATER WELL DRILLERS LOG

4-10 19 67 Intertec Well Works Hancock  
 date well completed firm name county well located

LANDOWNER: Mrs. HAZEL STEPHENS

description of formations encountered

from to

Box 336

Waveland Miss.  
(mailing address)

WELL LOCATION:


sec. 7 T. 9 N. R. 14 E.  
 S W  
1 miles N of Clement Harbor  
 (distance) (direction) (nearest town)

WELL PURPOSE: Home  
(home, irrigation, municipal, industrial)

WELL COMPLETION DATA:


- (1) diameter (inches) 2
- (2) total depth (feet) 165
- (3) static water level (feet) 7 below above top of ground.
- (4) casing galv. 160'  
(material) (depth)
- (size) If telescope see back.
- (5) screen 5' 160'  
(length) (depth to top)
- 2" stainless steel  
(size) (material)
- (6) pump 1/2 10  
(HP) (yield gpm)
- elec  
(type power)
- (7) electric log No  
(yes or no)
- (organization running log)
- (8) how well bottom plugged B.P. Value

DRILLERS REMARKS:

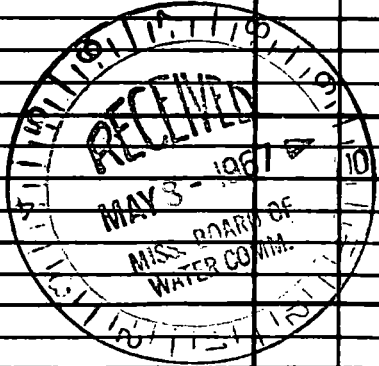

If well telescopes please sketch and show depths.

GROUND LEVEL

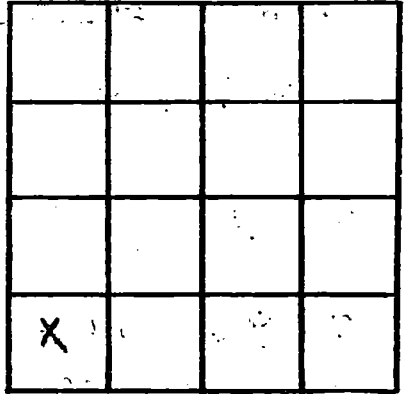

SECTION 7

Please indicate well location X.

ADDITIONAL INFORMATION

Lined area for additional information.

If more than one screen, show locations of each on sketch.