

K 3044

Hancock
~~A 2069~~
7-67

MISSISSIPPI
BOARD OF WATER COMMISSIONERS
416 North State Street
Jackson, Mississippi 39201

WATER WELL DRILLERS LOG *Well # 2*

7-27 1967 Lutter Waco Washel Hancock
date well completed firm name county well located

LANDOWNER: First Assy of
God Church

description of formations encountered	from	to
Clay	0	16
sand	16	37
Clay	37	93
sand & gravel	93	128
Clay	128	195
sand	195	213

Waveland, Miss.
(mailing address)

WELL LOCATION:

sec. 3 T 9 N R 14 E
S W
1 miles N of Waveland
(distance) (direction) (nearest town)

WELL PURPOSE: Church Rectory
(home, irrigation, municipal, industrial)


WELL COMPLETION DATA:

- (1) diameter (inches) 2
- (2) total depth (feet) 213
- (3) static water level (feet) 76 below top of ground.
- (4) casing galv. 203
(material) (depth)
2" if telescope see back.
(size)
- (5) screen 10' 203'
(length) (depth to top)
2" brass
(size) (material)
- (6) pump unknown
(HP) (yield gpm)

(type power)
(7) electric log no
(yes or no)

(organization running log)
(8) how well bottom plugged BPT Value

DRILLERS REMARKS:

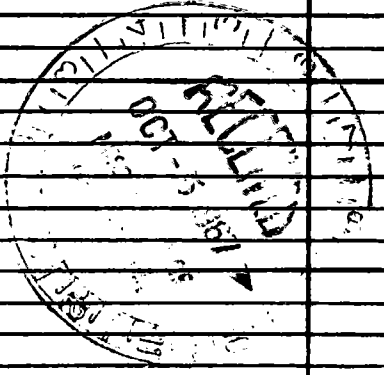

If well telescopes please sketch and show depths.

GROUND LEVEL

X			

SECTION 3

Please indicate well location X.

ADDITIONAL INFORMATION

If more than one screen, show locations of each on sketch.