

K3046

Hancock  
#2064  
9-67

MISSISSIPPI  
BOARD OF WATER COMMISSIONERS  
416 North State Street  
Jackson, Mississippi 39201

WATER WELL DRILLERS LOG

9-29 1967 Sutter Well Works Hancock  
date well completed firm name county well located

LANDOWNER: Chas. Jackson

Box 197

Clermont Harbor, Miss.  
(mailing address)

WELL LOCATION:

sec. 8 T 9 S R. 14 W  
1 miles N of Clermont Harbor  
(distance) (direction) (nearest town)

WELL PURPOSE: Home  
(home, irrigation, municipal, industrial)

WELL COMPLETION DATA:

- (1) diameter (inches) 2
- (2) total depth (feet) 304
- (3) static water level (feet) 8 below top of ground
- (4) casing galv. 294' (material) (depth)  
2" (size) if telescope see back.
- (5) screen 10' 294' (length) (depth to top)  
2" stainless steel (size) (material)
- (6) pump unknown (HP) (yield gpm)
- (7) electric log no (yes or no)

(organization running log)


(8) how well bottom plugged B.P. Value

DRILLERS REMARKS:

description of formations encountered

from to

Clay	0	8
Sand	8	46
Clay	46	172
Sand	172	202
Clay	202	265
Sand	265	304

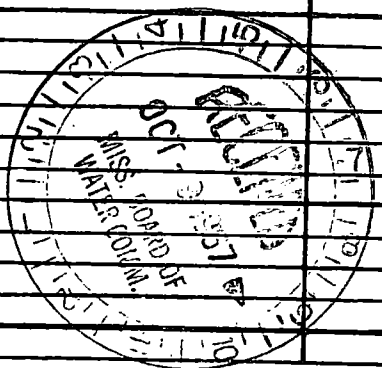

If well telescopes please sketch and show depths.

GROUND LEVEL

		X	

SECTION 8

Please indicate well location X.

ADDITIONAL INFORMATION

If more than one screen, show locations of each on sketch.