

K 3047

Hancock
At 7005
9-67

MISSISSIPPI
BOARD OF WATER COMMISSIONERS
416 North State Street
Jackson, Mississippi 39201

WATER WELL DRILLERS LOG

9-28 1967 date well completed Sutter Well Works firm name Hancock county well located

LANDOWNER: ORON PATILLO

description of formations encountered

from to

918 CONSTANTINOPLE

NEW ORLEANS LA.
(mailing address)

WELL LOCATION:

sec. 6 T 9 N R. 14 E
S W
4 miles W of Waveland
(distance) (direction) (nearest town)

WELL PURPOSE: home
(home, irrigation, municipal, industrial)

WELL COMPLETION DATA:

- (1) diameter (inches) 2
- (2) total depth (feet) 154
- (3) static water level (feet) 6 below above top of ground.
- (4) casing galv. 149'
(material) (depth)
2" if telescope see back.
(size)
- (5) screen 5' 149'
(length) (depth to top)
2" stainless steel
(size) (material)
- (6) pump unknown
(HP) (yield gpm)


(type power)

(7) electric log no
(yes or no)

(organization running log)

(8) how well bottom plugged B.P. Value

DRILLERS REMARKS:

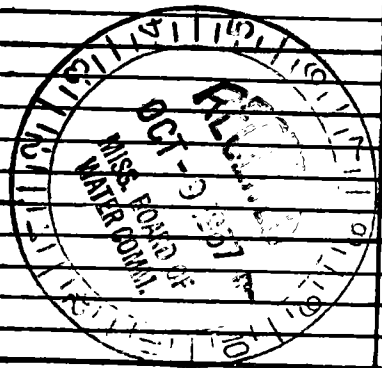

If well telescopes please sketch and show depths.

GROUND LEVEL

X			

SECTION 6

Please indicate well location X.

ADDITIONAL INFORMATION

If more than one screen, show locations of each on sketch.