

K3048

Hancock

2066

3-68

MISSISSIPPI BOARD OF WATER COMMISSIONERS
416 North State Street
Jackson, Mississippi 39201

WATER WELL DRILLERS LOG

3-7 1968 date well completed

Sutter Wheel Works firm name

Hancock county well located

LANDOWNER: C. C. Newbig
2351 North Roman
New Orleans La.
(mailing address)


description of formations encountered	from to	
Clay	0	15
Sand	15	36
Clay	36	83
Sand	83	120
Clay	120	151
Sand	151	170

WELL LOCATION:
sec. 7 T. 9 R. 14
S W
4 miles west of Waveland
(distance) (direction) (nearest town)

WELL PURPOSE: Home
(home, irrigation, municipal, industrial)

WELL COMPLETION DATA:

- (1) diameter (Inches) 2
- (2) total depth (feet) 170
- (3) static water level (feet) 8 1/2 below top of ground.
- (4) casing Galv., 165'
(material) (depth)
2" If telescope see back.
(size)
- (5) screen 5', 165'
(length) (depth to top)
2" Stainless Steel
(size) (material)
- (6) pump 3/4 15
(HP) (yield gpm)
elec
(type power)
- (7) electric log no
(yes or no)
(organization running log)
- (8) how well bottom plugged BPU

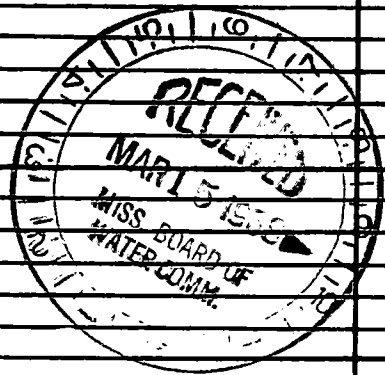

DRILLERS REMARKS:

If well telescopes please sketch and show depths.

GROUND LEVEL

X			

SECTION 7

Please indicate well location X.

ADDITIONAL INFORMATION

If more than one screen, show locations of each on sketch.