

K 3049

MANCOCK 17  
N 20 70  
3-68

MISSISSIPPI  
BOARD OF WATER COMMISSIONERS  
416 North State Street  
Jackson, Mississippi 39201

WATER WELL DRILLERS LOG

3-11 1968  
date well completed

Sutter Well Works  
firm name

Hancock  
county well located

LANDOWNER: F. S. Reiter

description of formations encountered

from to

23 West Carroll

Bay St. Louis, Miss.  
(mailing address)

Clay  
sand

0 14  
14 28

Clay  
sand

28 76  
76 98

Clay  
sand

98 147  
147 163


WELL LOCATION:

sec. 6 T. 9 S. R. 14 W.  
4 miles west of Waveland  
(distance) (direction) (nearest town)

WELL PURPOSE: home  
(home, irrigation, municipal, industrial)

WELL COMPLETION DATA:

- (1) diameter (inches) 2
- (2) total depth (feet) 163
- (3) static water level (feet) 5 below top of ground.
- (4) casing galv. 158' (material) (depth)  
2" (size) if telescope see back.
- (5) screen 5' 158' (length) (depth to top)  
2" stainless steel (size) (material)
- (6) pump unknown (HP) (yield gpm)  
elec (type power)
- (7) electric log no (yes or no)  
(organization running log)
- (8) how well bottom plugged B.P. Valve

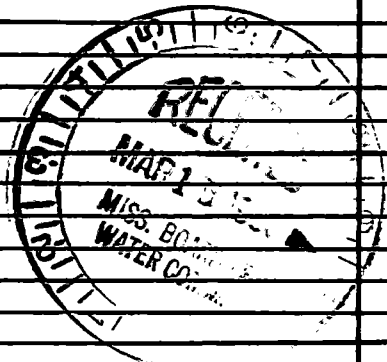

DRILLERS REMARKS:

