

K3051

Hancock

~~12-20-67~~

6-68

MISSISSIPPI  
 BOARD OF WATER COMMISSIONERS  
 416 North State Street  
 Jackson, Mississippi 39201

WATER WELL DRILLERS LOG

6-17 19 68 Sutter Well Works Hancock  
 date well completed firm name county well located

LANDOWNER: Mrs J. Marie  
Waveland, Miss

(mailing address)

WELL LOCATION:

sec. 8 T 9 N R 14 E  
 S W  
 \_\_\_\_\_ miles 1 1/2 IN of Waveland  
 (distance) (direction) (nearest town)

WELL PURPOSE: home  
 (home, irrigation, municipal, industrial)

WELL COMPLETION DATA:

- (1) diameter (inches) 2
- (2) total depth (feet) 173
- (3) static water level (feet) 10 1/2 below top of ground.
- (4) casing Galv., 159,  
 (material) (depth)  
2" if telescope see back.  
 (size)
- (5) screen 5', 159  
 (length) (depth to top)  
2", Stainless steel  
 (size) (material)
- (6) pump unknown  
 (HP) (yield gpm)  
 \_\_\_\_\_  
 (type power)
- (7) electric log No  
 (yes or no)  
 \_\_\_\_\_  
 (organization running log)
- (8) how well bottom plugged BP Valve

description of formations encountered

from to


Clay	0	15
Sand	15	79
Clay	79	146
sand	146	173

DRILLERS REMARKS:

JUN 27 1968  
 MISS. BOARD OF  
 WATER COMMISSIONERS

If well telescopes please sketch and show depths.

GROUND LEVEL

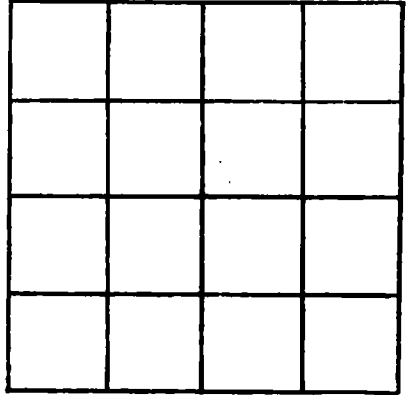

SECTION \_\_\_\_\_

Please indicate well location X.

ADDITIONAL INFORMATION

If more than one screen, show locations of each on sketch.