

K 3055

MISSISSIPPI
BOARD OF WATER COMMISSIONERS
416 North State Street
Jackson, Mississippi 39201

WATER WELL DRILLERS LOG

8-24 1968
date well completed

Lutter Well Works
firm name

Hancock
county well located

LANDOWNER: ¹⁹⁹² ELVIRA Colloghan

1003 MARION AVE

METAIRIE LOUISIANA
(mailing address)

description of formations encountered

from to

Clay	0	16
sand	16	35
clay	35	97
sand	97	132

WELL LOCATION:

sec. 6 T. 9 S. R. 14 E. W. 3 miles W Waveland
(distance) (direction) (nearest town)

WELL PURPOSE: home
(home, irrigation, municipal, industrial)


WELL COMPLETION DATA:

- (1) diameter (inches) 2
- (2) total depth (feet) 132
- (3) static water level (feet) 10 below above top of ground.
- (4) casing galv. 127' (material) (depth)
2" (size) If telescope see back.
- (5) screen 5' 127' (length) (depth to top)
2" (size) Stainless steel (material)
- (6) pump 1/2 10 (HP) (yield gpm)
elec (type power)
- (7) electric log no (yes or no)

(organization running log)

(8) how well bottom plugged BPU

DRILLERS REMARKS:

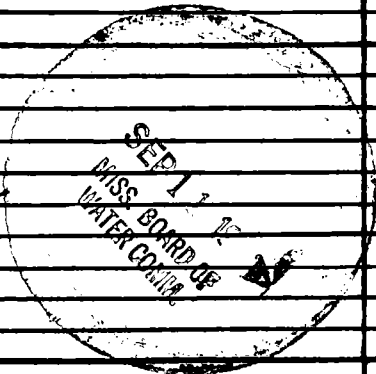

If well telescopes please sketch and show depths.

GROUND LEVEL

105
100
95
90
85

			200'
		X	

SECTION 6

Please indicate well location X.

ADDITIONAL INFORMATION

Handwritten notes in the additional information section include:

- 105
- 100
- 95
- 90
- 85
- 75
- 70
- 65
If more than one screen, show locations of each on sketch.