

MISSISSIPPI DEPARTMENT OF NATURAL RESOURCES
Bureau of Land and Water Resources
 Southport Mall
 P.O. Box 10631
 Jackson, Mississippi 39209
WATER WELL DRILLERS LOG

8

~~K#12~~
HANCOCK
 1-23-85

Jan. 23 1985 Ward Well Dlg Hancock
 date well completed firm name county well located

LANDOWNER Benient Calinette
West Newton St.
Bay St. Series ms.
 (mailing address)

WELL LOCATION:
 sec. 6 T. 9 N R. 14 E
7 miles W of Lawrence
 (distance) (direction) (nearest town)

WELL PURPOSE: Home
 (home, irrigation, municipal, industrial)

- WELL COMPLETION DATA:
- (1) diameter (inches) 2"
 - (2) total depth (feet) 168
 - (3) static water level (feet) 12 ^{below} _{above} top of ground.
 - (4) casing PVC, 158
 (material) (depth)
 (size) if telescope see back.
 - (5) screen 10', -
 (length) (depth to top)
2", PVC
 (size) (material)
 - (6) pump owner, -
 (HP) (yield gpm)
 (type power)
 - (7) electric log NO
 (yes or no)
N/A
 (organization running log)
 - (8) how well bottom plugged BWU

description of formations encountered	from	to
	<u>fill - clay</u>	<u>0</u>
<u>sd</u>	<u>12</u>	<u>44</u>
<u>clay</u>	<u>44</u>	<u>95</u>
<u>sd</u>	<u>95</u>	<u>132</u>
<u>clay - silt</u>	<u>132</u>	<u>154</u>
<u>Red gravel - sd</u>	<u>155</u>	<u>168</u>


DRILLERS REMARKS: N/A

RECEIVED
 APR 10 1985

Department of Natural Resources
 Bureau of Land & Water Resources

If well telescopes please sketch and show depths.

GROUND LEVEL

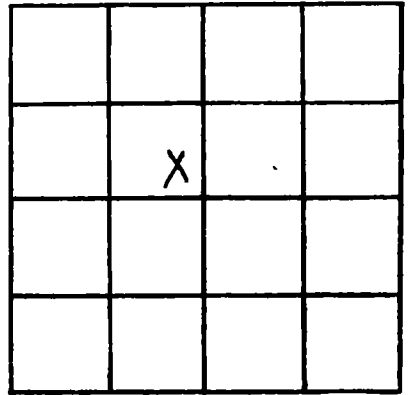

SECTION 6

Please indicate well location X.

ADDITIONAL INFORMATION

If more than one screen, show locations of each on sketch.