

K

K

WATER WELL DRILLERS LOG

8-10-60

Date: 8-10, 1960, Driller: Sutton Well Works County Hancock

(Name)

(1) Owner of Land: James Pollard
 (Name)
Rt. 2 Bay St. Louis
 (Address) Town

(2) Location: 1/4, 1/4, -Sec. T R
 miles ^{IN} of Bay
 (distance) (direction) (Nearest Town)

(3) Topography: flat
 (Hilly) (Flat) (Level)

(4) Purpose of Well: domestic
 (Domestic Irrigation
 Municipal, Industrial, Other)

Description & Color of Materials Sand, Clay, Red Clay, Shell, etc.	Thick- ness Feet	Depth Feet
Clay	10	10
sand	184	194
Clay	60	354
sand	6	360
Clay - sand streaks	120	480
sand	21	501

Information upon completion of well:

(1) Diameter 2 inches.

(2) Total Depth 501 feet.

(3) Water Level 17 feet below top of ground.

(4) Cased to all, Size 2"


(5) Screen: Size 2", Length 10'

(6) Were any formations sealed against pollution?
 yes, no.

If YES depth of formation

Why

Drillers Remarks:

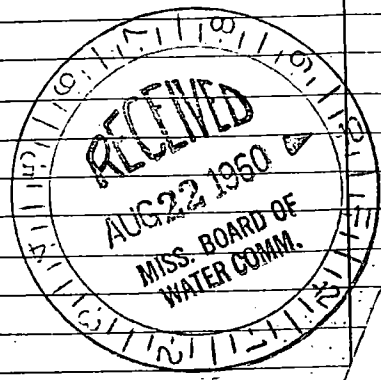

(Use Back Side)

