

K

8-1-61

WATER WELL DRILLERS LOG

Date: 8-1, 1961, Driller: Sutton Well Wks. County Hancock  
 (Name)

(1) Owner of Land:	Description & Color of Materials Sand, Clay, Red Clay, Shell, etc.	Thick- ness Feet	Depth Feet
(Name) <u>Unknown</u> (Address) <u>Bay St. Louis Miss.</u>	Clay	20	20
(2) Location: <u>1/4</u> , <u>1/4</u> , Sec. <u>T</u> <u>R</u> <u>6</u> miles <u>NW</u> of <u>Bay St. Louis</u> (distance) (direction) (Nearest Town)	Sand	15	35
(3) Topography: <u>Flat</u> (Hilly) (Flat) (Level)	Clay	105	140
(4) Purpose of Well: <u>domestic</u> (Domestic Irrigation Municipal, Industrial, Other)	Sand, gravel	10	150


Information upon completion of well:

- (1) Diameter 1 1/4 inches.
- (2) Total Depth 150 feet.
- (3) Water Level — feet below top of ground.
- (4) Cased to all, Size 1 1/4"
- (5) Screen: Size 1 1/4", Length 5'
- (6) Were any formations sealed against pollution?  
— yes,  no.

If YES depth of formation \_\_\_\_\_

Why \_\_\_\_\_

Drillers Remarks: Contracted for by  
Earl Garcia of Bay St.  
Louis, Miss.

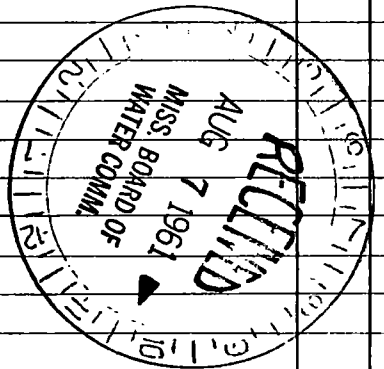

(Use Back Side)

Well No.

