

WATER WELL DRILLERS LOG

6-21-62

Date: 6-21, 1962, Driller: Sutter Well Works County Hancock

(Name)

(1) Owner of Land: Carleton West

(Name)

(Address)

(2) Location: NW 1/4 SE 1/4, Sec. 40 T8S R14W

3 miles NW of Bogalusa

(distance)

(direction)

(Nearest Town)

(3) Topography: flat

(Hilly)

(Flat)

(Level)

(4) Purpose of Well: domestic

(Domestic Irrigation
Municipal, Industrial, Other)

Information upon completion of well:

- (1) Diameter 2 inches.
- (2) Total Depth 152 feet.
- (3) Water Level 2 feet below top of ground.
- (4) Cased to well, Size 2"
- (5) Screen: Size 2", Length 5'
- (6) Were any formations sealed against pollution?
yes, no.

If YES depth of formation

Why


Drillers Remarks:

Description & Color of Materials
Sand, Clay, Red Clay, Shell, etc.

Thick-
ness
Feet

Depth
Feet

Clay - sand streaks	135	135
Sand	17	152

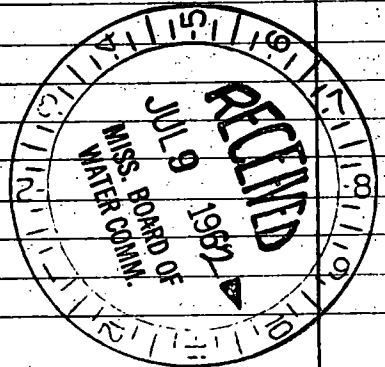

(Use Back Side)

Well No.

1
2
1
2
3
100