

WATER WELL DRILLERS LOG

6-18-62

Date: 6-18, 1962, Driller: Sutter Well Works County Hancock

(Name)

(1) Owner of Land: Meyers (Name) Bay St. Louis (Address)

Description & Color of Materials Sand, Clay, Red Clay, Shell, etc.	Thick- ness Feet	Depth Feet
Clay - sand streaks	173	173
sand	7	180

(2) Location: NW 1/4, NE 1/4, Sec. 46 T85R N, W 3 miles NW of Bay St. Louis

(3) Topography: flat (Hilly) (Flat) (Level)

(4) Purpose of Well: domestic (Domestic irrigation, Municipal, Industrial, Other)


Information upon completion of well:

- (1) Diameter 2 inches.
- (2) Total Depth 180 feet.
- (3) Water Level 3 feet below top of ground.
- (4) Cased to all, Size 2"
- (5) Screen: Size 2", Length 5'
- (6) Were any formations sealed against pollution?
yes, no.

If YES depth of formation

Why

Drillers Remarks:

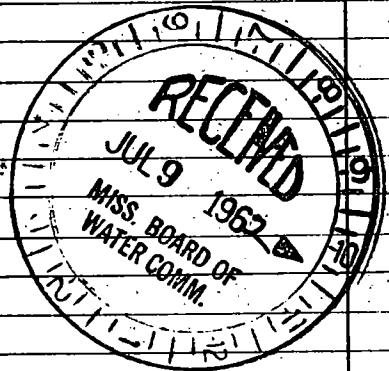

(Use Back Side)

Well No.

Handwritten notes at the top of the page, including the word "Experiment" and other illegible scribbles.

A large table with a grid of horizontal and vertical lines, mostly empty, occupying the left side of the page.

Handwritten notes on the right side of the page, including the word "Experiment" and other illegible scribbles.

Handwritten notes on the right side of the page, including the word "Experiment" and other illegible scribbles.

