

HANCOCK

MISSISSIPPI BOARD OF WATER COMMISSIONERS

K

WATER WELL DRILLERS LOG

4-30-62

Date: 4-30, 1962, Driller: Sutter Well Wash County Hancock

(Name)

(1) Owner of Land: <u>Leenie Way</u> (Name)	Description & Color of Materials Sand, Clay, Red Clay, Shell, etc.	Thick- ness Feet	Depth Feet
(Address)	Clay	10	10
(2) Location: <u>NW 1/4, NE 1/4, Sec. 46 T85R14, W</u>	Sand	27	37
<u>3</u> miles <u>NW</u> of <u>Bay St Louis</u> (distance) (direction) (Nearest Town)	Clay	80	117
(3) Topography: <u>flat</u> (Hilly) (Flat) (Level)	Sand	30	147
(4) Purpose of Well: <u>domestic</u> (Domestic Irrigation Municipal, Industrial, Other)			


Information upon completion of well:

- (1) Diameter 1 1/4 inches.
- (2) Total Depth 147 feet.
- (3) Water Level surface ^{above} feet below top of ground.
- (4) Cased ~~to~~ all, Size 1 1/4"
- (5) Screen: Size 1 1/4", Length 5'
- (6) Were any formations sealed against pollution?
no

If YES depth of formation

Why

Drillers Remarks:

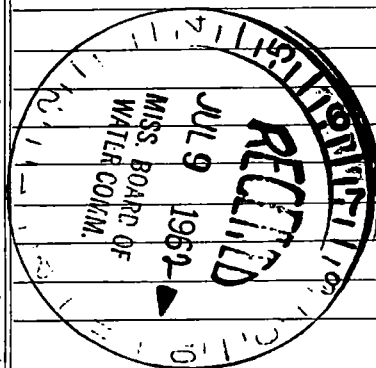

(Use Back Side)

Well No.

1914

1914

