

HANCOCK
K

5-27-66 MISSISSIPPI BOARD OF WATER COMMISSIONERS

WATER WELL DRILLERS LOG

Date: 5-27, 1966, Driller: Sutton Well Works County Hancock
(When well drilled) (Name) (Where well is located)

(1) Owner of Land:	Description & Color of Materials Sand, Clay, Red Clay, Shell, etc.	Thick- ness Feet	Depth Feet
<u>Hyde Construction Co.</u> (Name)	<u>Clay</u>	<u>18</u>	<u>18</u>
<u>Bay St. Louis, Miss.</u> (Address)	<u>sand - Clay streak</u>	<u>172</u>	<u>190</u>
(2) Location: <u>SW 1/4, NE 1/4, Sec. 34 T85R14W</u>	<u>Clay</u>	<u>215</u>	<u>405</u>
<u>3</u> miles <u>W</u> , of <u>Bay St. Louis</u> (distance) (direction) (Nearest Town)	<u>sand</u>	<u>60</u>	<u>465</u>
(3) Topography: <u>flat</u> (Hilly) (Flat) (Level)			
(4) Purpose of Well: <u>Industrial</u> (Domestic Irrigation Municipal, Industrial, Other)			

Information upon completion of well:

(1) Diameter 6 inches.

(2) Total Depth 465 feet.

(3) Water Level 1 feet below top of ground.

(4) Cased to all, Size 6"

(5) Screen: Size 6", Length 20'

(6) Were any formations sealed against pollution?
 yes, no.

If YES depth of formation _____


Why _____

Drillers Remarks: _____

Yield in gpm: 200

Size pump: 15 hp sub.

Type power: Elec

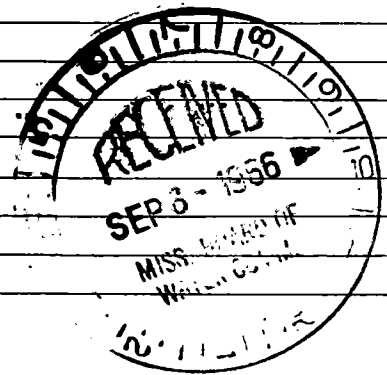

Mail this copy to Board of Water Commissioners 429 Miss. St. Jackson, Miss.

1

Handwritten text, mostly illegible due to extreme blurriness and low contrast. The text appears to be organized into several sections or paragraphs, with some lines starting with capital letters. There are some faint markings that could be interpreted as "Page 1" at the top center.