

K
8-16-60
WATER WELL DRILLERS LOG

Date: 8-16, 1960, Driller: Jutter Well Works County Hancock
(Name)

(1) Owner of Land: A.E. LABARRE
(Name)
Bay St. Louis, Miss.
(Address)

(2) Location: 1/4, 1/4, Sec. T R
2 miles W of Bay
(distance) (direction) (Nearest Town)

(3) Topography: Flat
(Hilly) (Flat) (Level)

(4) Purpose of Well: domestic
(Domestic Irrigation
Municipal, Industrial, Other)

Description & Color of Materials Sand, Clay, Red Clay, Shell, etc.	Thick- ness Feet	Depth Feet
Surface clay	10	10
sand	50	60
Clay	25	85
sand	35	120
Clay streaks	280	400
sand	80	480
Clay	110	590
sand	125	715
Clay	175	890
sand	42	1032
Clay	72	1104
sand	51	1155

Information upon completion of well:

(1) Diameter 2 inches.

(2) Total Depth 1155 feet.

(3) Water Level 45 feet above below top of ground.

(4) Cased with all, Size 2"


(5) Screen: Size 2", Length 20'

(6) Were any formations sealed against pollution?
 yes, no.

If YES depth of formation _____

Why _____

Drillers Remarks: _____

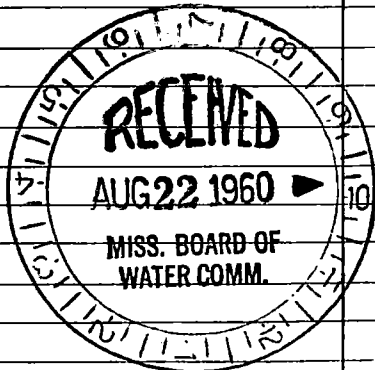

(Use Back Side)

Well No.

