

K

K ✓

WATER WELL DRILLERS LOG

6-5-61

Date: 6-5, 1961, Driller: Sutter Well Works County Hancock

(Name)


(1) Owner of Land: <u>PHILLIP PENDERGAST</u> (Name)	Description & Color of Materials Sand, Clay, Red Clay, Shell, etc.	Thick- ness Feet	Depth Feet
* (Address)	<u>Clay</u>	<u>14</u>	<u>14</u>
(2) Location: <u>1/4</u> , <u>1/4</u> , Sec. <u>8 SR 44</u>	<u>sand</u>	<u>5</u>	<u>19</u>
<u>4</u> miles <u>NW</u> , of <u>Bay St. Louis</u> (distance) (direction) (Nearest Town)	<u>Clay</u>	<u>103</u>	<u>122</u>
(3) Topography: <u>flat</u> (Hilly) (Flat) (Level)	<u>sand</u>	<u>33</u>	<u>155</u>
(4) Purpose of Well: <u>domestic home</u> (Domestic Irrigation Municipal, Industrial, Other)			

Information upon completion of well:

- (1) Diameter 1 1/4 inches.
- (2) Total Depth 155 feet. Flow
- (3) Water Level 2 feet above below top of ground.
- (4) Cased ~~to~~ 151 Rel, Size 1 1/4"
- (5) Screen: Size 1 1/4", Length 5'
- (6) Were any formations sealed against pollution?  
 yes,  no.

If YES depth of formation \_\_\_\_\_  
Why \_\_\_\_\_

Drillers Remarks: \* Contract made  
thru builder of home.  
Address unknown.

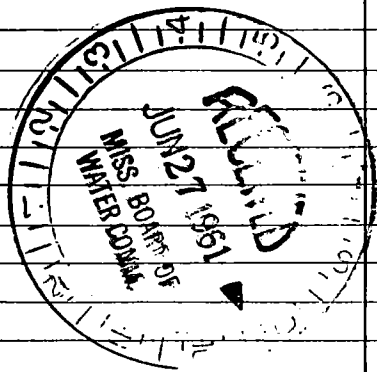

(Use Back Side)

Well No.

Account of the ...

...

...

