

HANCOCK
K

WATER WELL DRILLERS LOG

4-28-61

Date: 4-28, 1961, Driller: Sutter Well Works County Hancock

(Name)

(1) Owner of Land: H. L. Lee
(Name)

Picayune
(Address) TOWNSHIP

(2) Location: 1/4, 1/4, Sec. T. R.

1 miles W of Bay
(distance) (direction) (Nearest Town)

(3) Topography: flat
(Hilly) (Flat) (Level)

(4) Purpose of Well: domestic
(Domestic Irrigation
Municipal, Industrial, Other)

Description & Color of Materials
Sand, Clay, Red Clay, Shell, etc.

Thick-
ness
Feet

Depth
Feet

<u>sand</u>	<u>45</u>	<u>45</u>
<u>Clay</u>	<u>35</u>	<u>80</u>
<u>sand</u>	<u>30</u>	<u>110</u>
<u>Clay</u>	<u>295</u>	<u>405</u>
<u>sand</u>	<u>58</u>	<u>463</u>
<u>Clay</u>	<u>15</u>	<u>478</u>
<u>sand</u>	<u>32</u>	<u>510</u>
<u>Clay</u>	<u>65</u>	<u>575</u>
<u>sand</u>	<u>60</u>	<u>635</u>

Information upon completion of well:

(1) Diameter 2 inches.

(2) Total Depth 635 feet.

(3) Water Level 15 feet above below top of ground.

(4) Cased to all, Size 2"

(5) Screen: Size 2", Length 18'


(6) Were any formations sealed against pollution?

 yes, no.

If YES depth of formation

Why

Drillers Remarks:

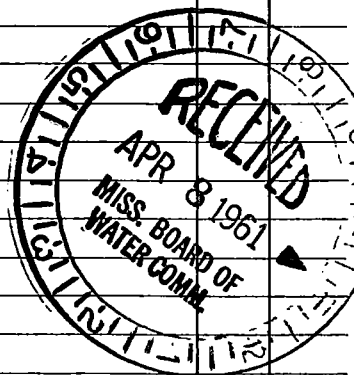

(Use Back Side)

Well No.

