

K.

10-25-61

WATER WELL DRILLERS LOG

Date: 10-25, 1961, Driller: Sutter Well Works County Hancock

(Name)

(1) Owner of Land: Earl Garcia  
(Name)  
Bay St. Louis Miss.  
(Address)

(2) Location: SW 1/4, NE 1/4, Sec. 47 T85R14W  
3 miles NW of Bay St. Louis  
(distance) (direction) (Nearest Town)

(3) Topography: flat  
(Hilly) (flat) (Level)

(4) Purpose of Well: domestic  
(Domestic Irrigation  
 Municipal, Industrial, Other)

Description & Color of Materials Sand, Clay, Red Clay, Shell, etc.	Thick- ness Feet	Depth Feet
clay	10	10
sand	40	50
clay	46	96
sand	36	132

Information upon completion of well:

(1) Diameter 2x1/4 inches.

(2) Total Depth 132 feet.

(3) Water Level flow feet below top of ground.

(4) Cased to all, Size 3 3/4", Size TOP 36' 2" 3 1/4"


(5) Screen: Size 2", Length 5'

(6) Were any formations sealed against pollution?  
 \_\_\_\_\_ yes,  no.

If YES depth of formation \_\_\_\_\_

Why \_\_\_\_\_

Drillers Remarks: \_\_\_\_\_

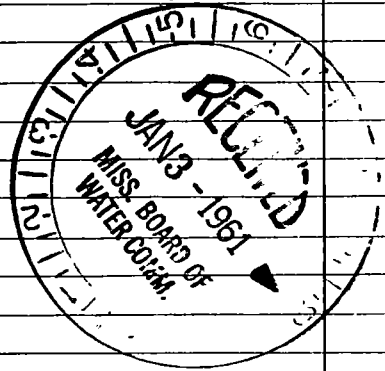

(Use Back Side)

Well No.

12-31

12-31

12-31

10 10  
20 20  
30 30  
40 40  
50 50

10 10  
20 20  
30 30  
40 40  
50 50

