

HANCOCK
K

MISSISSIPPI BOARD OF WATER COMMISSIONERS

K

8-29-61

WATER WELL DRILLERS LOG

Date: 8-29, 1961, Driller: Sutter Well Wks. County Hancock

(Name)

(1) Owner of Land:	Description & Color of Materials Sand, Clay, Red Clay, Shell, etc.	Thick- ness Feet	Depth Feet
Blossman Gas Co. <small>(Name)</small> Highway 90 - Bay St. Louis <small>(Address)</small>	Sand	84	84
(2) Location: _____ 1/4, _____ 1/4, Sec. _____ T R _____	Clay	96	180
_____ miles _____ <small>(distance)</small> <small>(direction)</small> of _____ <small>(Nearest Town)</small>	Sand	24	204
(3) Topography: _____ <small>(Hilly)</small> <small>(Flat)</small> <small>(Level)</small>			
(4) Purpose of Well: Industrial <small>(Domestic Irrigation Municipal, Industrial, Other)</small>			


Information upon completion of well:

- (1) Diameter 2 inches.
- (2) Total Depth 204 feet.
- (3) Water Level 8 feet below top of ground.
- (4) Cased to all, Size 2"
- (5) Screen: Size 2", Length 5'
- (6) Were any formations sealed against pollution?
 yes, no.

If YES depth of formation _____

Why _____

Drillers Remarks: _____

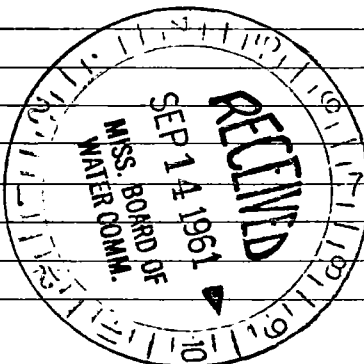

(Use Back Side)

Well No.

