

K.  
8-1-61

WATER WELL DRILLERS LOG

Date: 8-1, 1961, Driller: Sutter Well Works County Hancock  
(Name)

(1) Owner of Land: Unknown  
(Name)  
Bay St. Louis, Miss.  
(Address)

(2) Location: 1/4, 1/4, Sec. T R R  
6 miles NW, of Bay St. Louis  
(distance) (direction) (Nearest Town)

(3) Topography: Flat  
(Hilly) (Flat) (Level)

(4) Purpose of Well: domestic  
(Domestic Irrigation  
Municipal, Industrial, Other)

Description & Color of Materials Sand, Clay, Red Clay, Shell, etc.	Thick- ness Feet	Depth Feet
Clay	20	20
sand	15	35
Clay	100	130
sand	22	152

Information upon completion of well:

(1) Diameter 1 1/4 inches.

(2) Total Depth 152 feet.

(3) Water Level 6" above ~~feet below~~ top of ground.


(4) Cased to all, Size 1 1/4"

(5) Screen: Size 1 1/4", Length 5'

(6) Were any formations sealed against pollution?  
yes,  no.

If YES depth of formation \_\_\_\_\_  
Why \_\_\_\_\_

Drillers Remarks: Contracted for  
by Earl Garcia of  
Bay St. Louis, Miss.

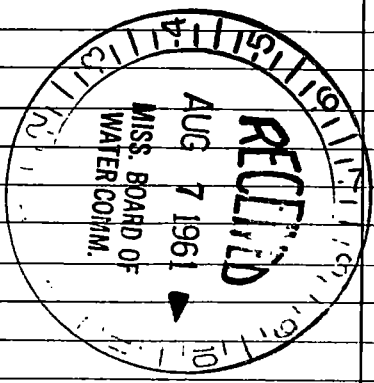

Well No.

(Use Back Side)

