

WATER WELL DRILLERS LOG

8-9-61

Date: 8-9, 1961, Driller: Sutter Well Wks. County Hancock

(Name)

(1) Owner of Land:	Description & Color of Materials Sand, Clay, Red Clay, Shell, etc.	Thick- ness Feet	Depth Feet
Onelia Parent (Name) Bay St. Louis, Miss. (Address)	Clay	36	36
	sand	79	115
(2) Location: 1/4, 1/4, Sec. T R, miles in of Bay St. Louis (distance) (direction) (Nearest Town)	Clay	119	234
	sand	35	269
	Clay	42	311
	sand	81	392
(3) Topography: level (Hilly) (Flat) (Level)	Clay	113	505
	sand	37	542
(4) Purpose of Well: domestic (Domestic Irrigation Municipal, Industrial, Other)	Clay	13	555
	sand	83	638
	Clay	24	662
	sand	40	702


Information upon completion of well:

- (1) Diameter 2 inches.
- (2) Total Depth 702 feet.
- (3) Water Level 30' (13#) above foot below top of ground.
- (4) Cased to all, Size 2"
- (5) Screen: Size 2", Length 16'
- (6) Were any formations sealed against pollution?  
yes,  no.

If YES depth of formation \_\_\_\_\_

Why \_\_\_\_\_

Drillers Remarks: \_\_\_\_\_

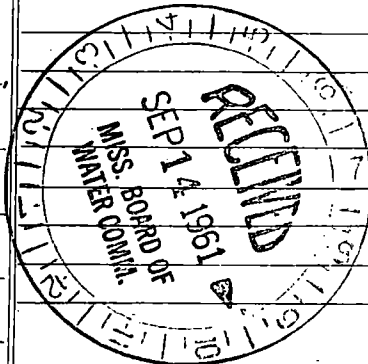

(Use Back Side)

Well No.

Handwritten header or title at the top of the page, possibly including a date or reference number.

Main body of handwritten text, appearing as a list or series of entries, possibly names or dates, arranged in a somewhat vertical or columnar fashion.

Lower section of handwritten text, continuing the list or entries, with some lines appearing more distinct than others.