

HANCOCK

K

K

8-10-61

WATER WELL DRILLERS LOG

Date: 8-10, 1961, Driller: Sutter Well Works County Hancock
(Name)

(1) Owner of Land: Frank P Valgado
(Name)
3615 Alvar St. N.O. 17 La
(Address)

(2) Location: 1/4, 1/4, Sec. T R,
5 miles NW of Baptistown
(distance) (direction) (Nearest Town)

(3) Topography: flat
(Hilly) (Flat) (Level)

(4) Purpose of Well: domestic
(Domestic Irrigation
Municipal, Industrial, Other)

Description & Color of Materials Sand, Clay, Red Clay, Shell, etc.	Thick- ness Feet	Depth Feet
<u>Sand</u>	<u>42</u>	<u>42</u>
<u>Clay</u>	<u>73</u>	<u>115</u>
<u>Sand</u>	<u>37</u>	<u>152</u>

Information upon completion of well:

(1) Diameter 1 1/4 inches.

(2) Total Depth 152 feet.

(3) Water Level 2 feet above below top of ground.

(4) Cased to 1 1/4", Size all.


(5) Screen: Size 1 1/4", Length 5'.

(6) Were any formations sealed against pollution?
no.

If YES depth of formation _____

Why _____

Drillers Remarks: _____

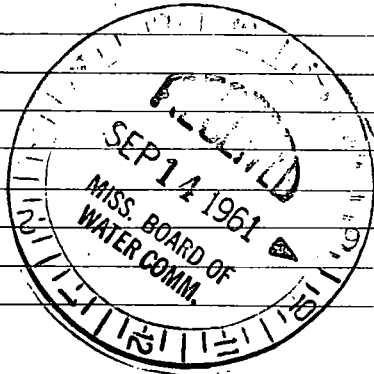

Well No.

(Use Back Side)

Handwritten text at the top of the page, possibly a header or title, including the word "Handwritten" and some illegible characters.

Handwritten text in the middle section of the page, appearing to be a signature or a specific label.

Main body of handwritten text, consisting of several lines of illegible script, possibly representing a list or a detailed note.