

HANCOCK

MISSISSIPPI BOARD OF WATER COMMISSIONERS

L5

7-27-61

WATER WELL DRILLERS LOG

CODED

Date: 7-27, 1961, Driller: Sutter Well Wks. County Hancock
(Name)

- (1) Owner of Land: Benj. Baker
(Name)
Gen Road - Pearlinton
(Address)
- (2) Location: 1/4, 1/4, Sec. 17 T. 9 R. 16,
1/4 miles IN Pearlinton
(distance) (direction) (Nearest Town)
- (3) Topography: flat
(Hilly) (Flat) (Level)
- (4) Purpose of Well: domestic
(Domestic Irrigation
Municipal, Industrial, Other)

Description & Color of Materials Sand, Clay, Red Clay, Shell, etc.	Thick- ness Feet	Depth Feet
<u>Clay</u>	<u>20</u>	<u>20</u>
<u>sand & gravel</u>	<u>45</u>	<u>65</u>
<u>blue clay</u>	<u>51</u>	<u>116</u>
<u>sand & gravel</u>	<u>15</u>	<u>131</u>

Information upon completion of well:


- (1) Diameter 2 inches.
- (2) Total Depth 131 feet.
- (3) Water level 8 feet below top of ground.
- (4) Cased to all, Size 2"
- (5) Screen: Size 2", Length 5'
- (6) Were any formations sealed against pollution?
no yes, no.

If YES depth of formation _____

Why _____

Drillers Remarks: _____

CODED

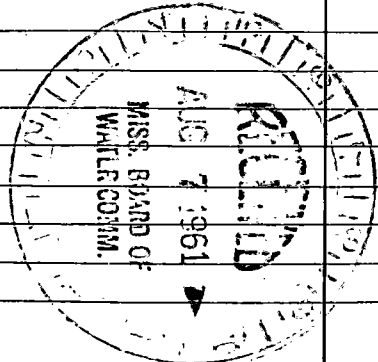

(Use Back Side)

Well No.

