

HANCOCK MISSISSIPPI BOARD OF WATER COMMISSIONERS

L 6

12-17-65

WATER WELL DRILLERS LOG

CODED

Date: 12-17, 1965, Driller: Sutter Well Works County Hancock

(Name)

(1) Owner of Land: Howard Garberough
(Name)
Pearlington, Miss.
(Address)

(2) Location: 1/4, 1/4, Sec. 17 T9 R6,
1/4 miles IN of Pearlington,
(distance) (direction) (Nearest town)

(3) Topography: flat
(Hilly) (Flat) (Level)

(4) Purpose of Well: domestic
(Domestic Irrigation
Municipal, Industrial, Other)

Description & Color of Materials Sand, Clay, Red Clay, Shell, etc.	Thick- ness Feet	Depth Feet
Clay - sand streaks	50	50
sand	38	88
Clay	56	144
sand	21	165
Clay	68	233
sand	19	252
Clay	139	391
sand	87	478
Clay	19	497
sand	43	540

Information upon completion of well:


- (1) Diameter 2 inches.
- (2) Total Depth 540 feet.
- (3) Water Level 7 above feet below top of ground.
- (4) Cased to all, Size 2"
- (5) Screen: Size 2", Length 15'
- (6) Were any formations sealed against pollution?
no

If YES depth of formation _____

Why _____

Drillers Remarks: _____

CODED

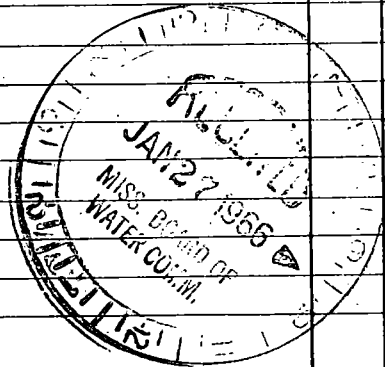

(Use Back Side)

Well No.

