

HANCOCK  
L15  
12-6-72

MISSISSIPPI  
 BOARD OF WATER COMMISSIONERS  
 416 North State Street  
 Jackson, Mississippi 39201

**CODED**


WATER WELL DRILLERS LOG

Dec. 6 19 72 Sutter Well Works Hancock  
 date well completed firm name county well located

LANDOWNER: <u>Ralph Brysson</u>	description of formations encountered	from	to
Box 92			
<u>Pearlington, Miss.</u>	Clay	0	90
(mailing address)	Sand	90	118
WELL LOCATION:	Clay	118	245
sec. <u>28</u> T <u>9</u> <del>XX</del> R <u>16</u> <del>XX</del>	Sand	245	266
S W	Clay	266	295
<u>2</u> miles S of <u>Pearlington</u>	Sand	295	330
(distance) (direction) (nearest town)	Clay	330	341
WELL PURPOSE: <u>home</u>	Sand	341	352
(home, irrigation, municipal, industrial)	Clay	352	380
WELL COMPLETION DATA:	Sand	380	401
(1) diameter (inches) <u>2"</u>	Clay	401	412
(2) total depth (feet) <u>467'</u>	Sand	412	467
(3) static water level (feet) <u>2'</u> <del>below</del> above top of ground.			
(4) casing <u>galv.</u> <u>457'</u>			
(material) (depth)			
<u>2"</u> if telescope see back.			
(size)			
(5) screen <u>10'</u> <u>457'</u>			
(length) (depth to top)			
<u>2"</u> stainless steel			
(size) (material)			
(6) pump <u>owner's</u>			
(HP) (yield gpm)			
<u>elec.</u>			
(type power)			
(7) electric log <u>no</u>			
(yes or no)			
(organization running log)			
(8) how well bottom plugged <u>b.p. valve</u>			
DRILLERS REMARKS:			

If well telescopes please sketch and show depths.

GROUND LEVEL

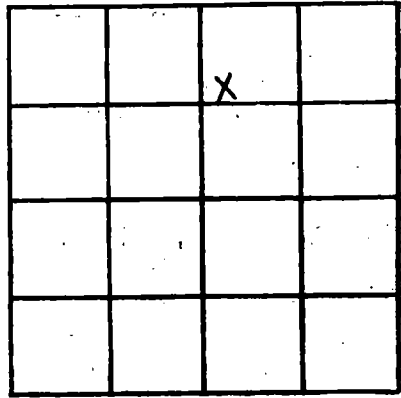

SECTION 28

Please indicate well location X.

ADDITIONAL INFORMATION

If more than one screen, show locations of each on sketch.