

HANCOCK

L 16

7-23-73

MISSISSIPPI BOARD OF WATER COMMISSION
416 North State Street
Jackson, Mississippi 39201

CODED

WATER WELL DRILLERS LOG

6-13-1973
date well completed

J.T. NARD WATERWELLS
firm name

HANCOCK
county well located

LANDOWNER: John L. Monty

P.O. Box 211

Pearlington, Miss.
(mailing address)

WELL LOCATION:

sec. 17 T 9 N R 16 E
18 miles W of B.S.L.
(distance) (direction) (nearest town)

WELL PURPOSE: Home
(home, irrigation, municipal, industrial)

WELL COMPLETION DATA:

- (1) diameter (inches) 2"
- (2) total depth (feet) 215'
- (3) static water level (feet) 7 ^{below} _{above} top of ground.

(4) casing 2" GALV. 210'
(material) (depth)

— if telescope see back.
(size)

(5) screen 5' —
(length) (depth to top)

2" 5.5'
(size) (material)

(6) pump 1/2 8
(HP) (yield gpm)

Elbe,
(type power)

(7) electric log NO
(yes or no)

N/A
(organization running log)

(8) how well bottom plugged BWU

description of formations encountered

from to

Sandy Clay

0 21

sd

21 33

dry clay

33 41

Redwood

41 62

clay sd

62 91

clay - silt

91 115

sd.

115 193

193 215


CODED

DRILLERS REMARKS: N/A

NO 11 1973

If well telescopes please sketch and show depths.

GROUND LEVEL

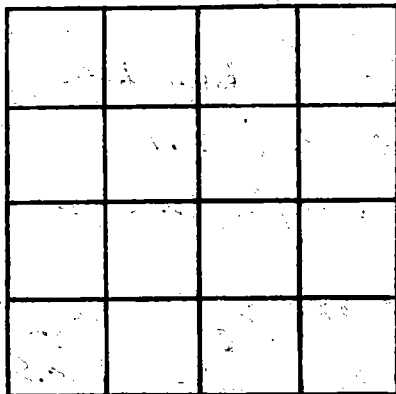

SECTION 17

Please indicate well location X.

ADDITIONAL INFORMATION

If more than one screen, show locations of each on sketch.