

HANCOCK
L 18
6-23-73

MISSISSIPPI
 BOARD OF WATER COMMISSIONERS
 416 North State Street
 Jackson, Mississippi 39201
WATER WELL DRILLERS LOG

CODED

Well is in
 Hancock
 County

June 23 1973 Mc Gil well works
 date well completed firm name county well located

LANDOWNER: Archie Larentz
712 N. Hudson St.
Metairie, La.
 (mailing address)

Description of formations encountered	from	to
clay	0	38
clay	38	61
clay	61	126
course sand	126	170


CODED

WELL LOCATION:
 sec. 29 T 9 N R 16 E
4 1/2 miles W of Bay St. Louis
 (distance) (direction) (nearest town)

WELL PURPOSE: Home
 (home, irrigation, municipal, industrial)

- WELL COMPLETION DATA:
- (1) diameter (inches) 2"
 - (2) total depth (feet) 170'
 - (3) static water level (feet) 1' below above top of ground.
 - (4) casing plastic 160'
 (material) (depth)
 (size) if telescope see back.
 - (5) screen 10' —
 (length) (depth to top)
2" plastic
 (size) (material)
 - (6) pump 1 13
 (HP) (yield gpm)
Electric
 (type power)
 - (7) electric log no
 (yes or no)
 (organization running log)
 - (8) how well bottom plugged sand
drift

DRILLERS REMARKS:

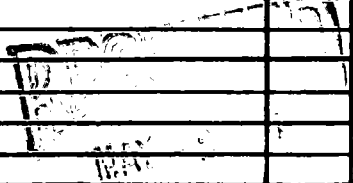

If well telescopes please sketch and show depths.

GROUND LEVEL

		X	

SECTION 29

Please indicate well location X.

ADDITIONAL INFORMATION

If more than one screen,
show locations of each on sketch.