

HANCOCK
L 19
5-3-74

MISSISSIPPI
BOARD OF WATER COMMISSIONERS
416 North State Street
Jackson, Mississippi 39201

CODED

WATER WELL DRILLERS LOG

5-3-1974 date well completed
ward well ply. firm name
Hancock county well located

LANDOWNER: Dennis Lewis
General Delivery
Dartington, Miss.
(mailing address)


WELL LOCATION:
sec 7 T 9 N R 16 E
18 miles S/W of B.S. L.
(distance) (direction) (nearest town)

WELL PURPOSE: Home
(home, irrigation, municipal, industrial)

- WELL COMPLETION DATA:
- (1) diameter (inches) 2"
 - (2) total depth (feet) 140
 - (3) static water level (feet) 7 below top of ground.
 - (4) casing PVC 135' (material) (depth)
If telescope see back.
(size)
 - (5) screen 5' (length) (depth to top)
2" PVC-SCH 80 (size) (material)
 - (6) pump (HP) (yield gpm)
(type power)
 - (7) electric log NO (yes or no)
N/A (organization running log)
 - (8) how well bottom plugged BWW

description of formations encountered	from	to
Top Soil - clay	0	16
sd	16	32
gray clay	32	45
sd - blue gravel	45	72
clay - shell	72	93
clay - silt	93	121
sd	121	140

CODED

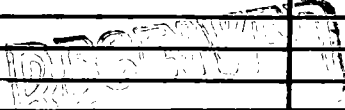

DRILLERS REMARKS:

MISS

COWIN

If well-telescopes please sketch and show depths.

GROUND LEVEL

SECTION 2

Please indicate well location X.

ADDITIONAL INFORMATION

If more than one screen, show locations of each on sketch.