

HANCOCK

L20

9-17-74

MISSISSIPPI BOARD OF WATER COMMISSIONERS
416 North State Street
Jackson, Mississippi

3920
CODED

WATER WELL DRILLERS LOG

9-17
date well completed

1974 Penitence Well Serv
firm name

HANCOCK
county well located

LANDOWNER: A.P. Wandrum

Peartington, Miss-

(mailing address)

WELL LOCATION:

sec 21 T 9 N R 16 W
S W
0 miles West of Peartington
(distance) (direction) (nearest town)

WELL PURPOSE: Home
(home, irrigation, municipal, industrial)

WELL COMPLETION DATA:

- (1) diameter (inches) 2
- (2) total depth (feet) 1910
- (3) static water level (feet) Flow ^{below} above top of ground.
- (4) casing Galv, 1890
(material) (depth)
2 if telescope see back.
(size)
- (5) screen 20, 1890
(length) (depth to top)
2, S. Steel
(size) (material)
- (6) pump _____
(HP) (yield gpm)
(type power)
- (7) electric log NO
(yes or no)
(organization running log)
- (8) how well bottom plugged BW Value

description of formations encountered

from to

Surface Clay	0	40
Sand	40	65
Blue Clay	65	180
Sand	180	185
Blue Clay	185	408
Sand	408	560
Blue Clay	560	1260
Fine Sand	1260	1270
Blue Clay	1270	1840
Sand	1840	1910

CODED


RECEIVED
OCT 24 1974

DRILLERS REMARKS: 37 lbs - Pressure

MISS. BD. OF WATER COMM

If well telescopes please sketch and show depths.

GROUND LEVEL

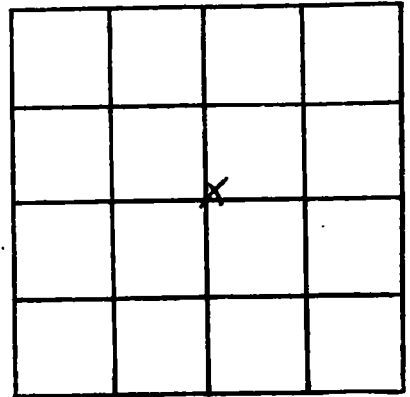

SECTION 21

Please indicate well location X.

ADDITIONAL INFORMATION

If more than one screen,
show locations of each on sketch.