

HANCOCK  
L 22  
2-5-75

MISSISSIPPI  
BOARD OF WATER COMMISSIONERS  
416 North State Street  
Jackson, Mississippi 39201

JED

WATER WELL DRILLERS LOG

Feb. 5 1975 Wood Well Drilling Hancock  
date well completed: firm name county well located

LANDOWNER Wimp's  
Po-Boy House  
Pearlington, Miss.  
(mailing address)

description of formations encountered	from	to
fill clay	0	16
sd	16	27
clay	27	42
Gravel - sd	42	67
clay-silt	67	89
sd - Good	89	103

WELL LOCATION  
sec. 19 T. 9 S. R. 16 E.  
15 miles W of B.S.L.  
(distance) (direction) (nearest town)

WELL PURPOSE: Business  
(home, irrigation, municipal, industrial)

WELL COMPLETION DATA:

(1) diameter (inches) 2"

(2) total depth (feet) 103

(3) static water level (feet) 8 below above top of ground.

(4) casing PVC 98  
(material) (depth)

- If telescope see back.  
(size)

(5) screen 5' -  
(length) (depth to top)

2" PVC  
(size) (material)

(6) pump 1/2 7  
(HP) (yield gpm)

Elec.  
(type power)

(7) electric log NO  
(yes or no)

N/A  
(organization running log)

(8) how well bottom plugged BWU


DRILLERS REMARKS: N/A

JUDED

RECEIVED  
FEB 10 1975

If well telescopes please sketch and show depths.

GROUND LEVEL

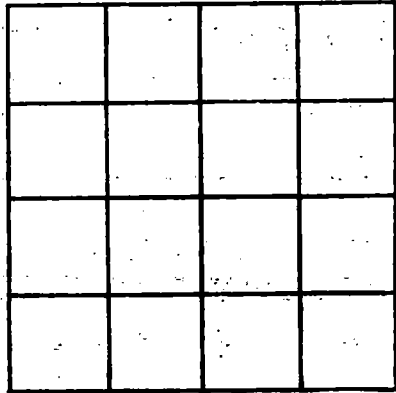

SECTION \_\_\_\_\_

Please indicate well location X.

ADDITIONAL INFORMATION

If more than one screen, show locations of each on sketch.