

**L 23**  
**5/12/75**  
**HANCOCK**

MISSISSIPPI  
 BOARD OF WATER COMMISSIONERS  
 416 North State Street  
 Jackson, Mississippi 39201

CODED

WATER WELL DRILLERS LOG

5-12 19 75 Penton Well Serv HANCOCK  
 date well completed firm name county well located

LANDOWNER: Randle Meyer Jr  
30 Riverside Dr.  
Pearlington Ms  
 (mailing address)

description of formations encountered	from	to
Surface Clay	0	28
Silt + Clay	28	50
Sand	50	65
Blue Clay	65	90
Sand	90	110

WELL LOCATION:  
 sec. 28 T. 9 S R. 16 W  
0 miles West of Pearlington  
 (distance) (direction) (nearest town)

WELL PURPOSE: Home  
 (home, irrigation, municipal, industrial)

- WELL COMPLETION DATA:
- (1) diameter (inches) 2
  - (2) total depth (feet) 110
  - (3) static water level (feet) 2 below top of ground
  - (4) casing Galv. 105  
 (material) (depth)  
2 If telescope see back.  
 (size)
  - (5) screen 5 105  
 (length) (depth to top)  
2 PVC  
 (size) (material)
  - (6) pump 1/2 12  
 (HP) (yield gpm)  
Elec  
 (type power)
  - (7) electric log NO  
 (yes or no)
  - (8) organization running log \_\_\_\_\_
  - (8) how well bottom plugged BW Valve


DRILLERS REMARKS: \_\_\_\_\_

REGISTERED  
 JUN 9 1975  
 MISS. BD. OF WATER COMM

Riverside Sub. Div.  
Belle Isle

If well telescopes please  
sketch and show depths.

GROUND LEVEL

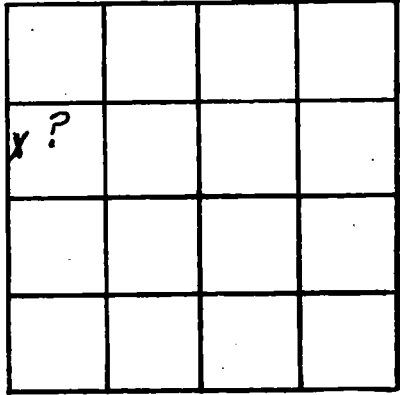

SECTION 28

Please indicate well location X.

ADDITIONAL INFORMATION

If more than one screen,  
show locations of each on sketch.