

Hancock  
L 2.4  
6-23-75

MISSISSIPPI  
 BOARD OF WATER COMMISSIONERS  
 416 North State Street  
 Jackson, Mississippi 39201

CODED

WATER WELL DRILLERS LOG

6-23- 1975 Woodwell Dlg. Hancock  
 date well completed firm name county well located

LANDOWNER: Mark Blackledge  
Rt. 2  
Bay St. Louis Miss  
 (mailing address)

WELL LOCATION:  
 sec. 28 T. 9 N. R. 14 E. <sup>13V</sup>  
15 miles W of B.S.L.  
 (distance) (direction) (nearest town)

WELL PURPOSE: Home  
 (home, irrigation, municipal, industrial)

WELL COMPLETION DATA:

(1) diameter (inches) 2"

(2) total depth (feet) 265

(3) static water level (feet) 9 <sup>below</sup> <sub>above</sub> top of ground.

(4) casing PVC 155  
 (material) (depth)  
 (size) if telescope see back.

(5) screen 10' -  
 (length) (depth to top)  
2" PVC  
 (size) (material)

(6) pump - -  
 (HP) (yield gpm)  
 (type power)

(7) electric log NO  
 (yes or no)  
N/A  
 (organization running log)

(8) how well bottom plugged BWW


description of formations encountered	from	to
top Soil - clay	0	15
sd	15	35
grey clay	35	76
clay - shell	76	95
Red - brown sd	95	116
clay	116	147
coarse sd	147	176
Blue clay	176	235
sd	235	265

DRILLERS REMARKS: N/A

RECEIVED  
 NOV 14 1975

If well telescopes please sketch and show depths.

GROUND LEVEL

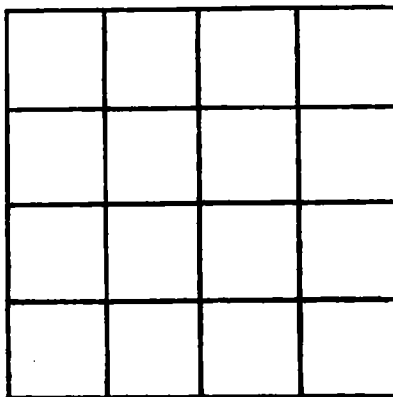

SECTION 28

Please indicate well location X.

ADDITIONAL INFORMATION

If more than one screen, show locations of each on sketch.